


UP TO DISCHARGE SILENCER OUTLET NOZZLE
IN SHEET NO. MS066(1/4)
WITHIN 10m

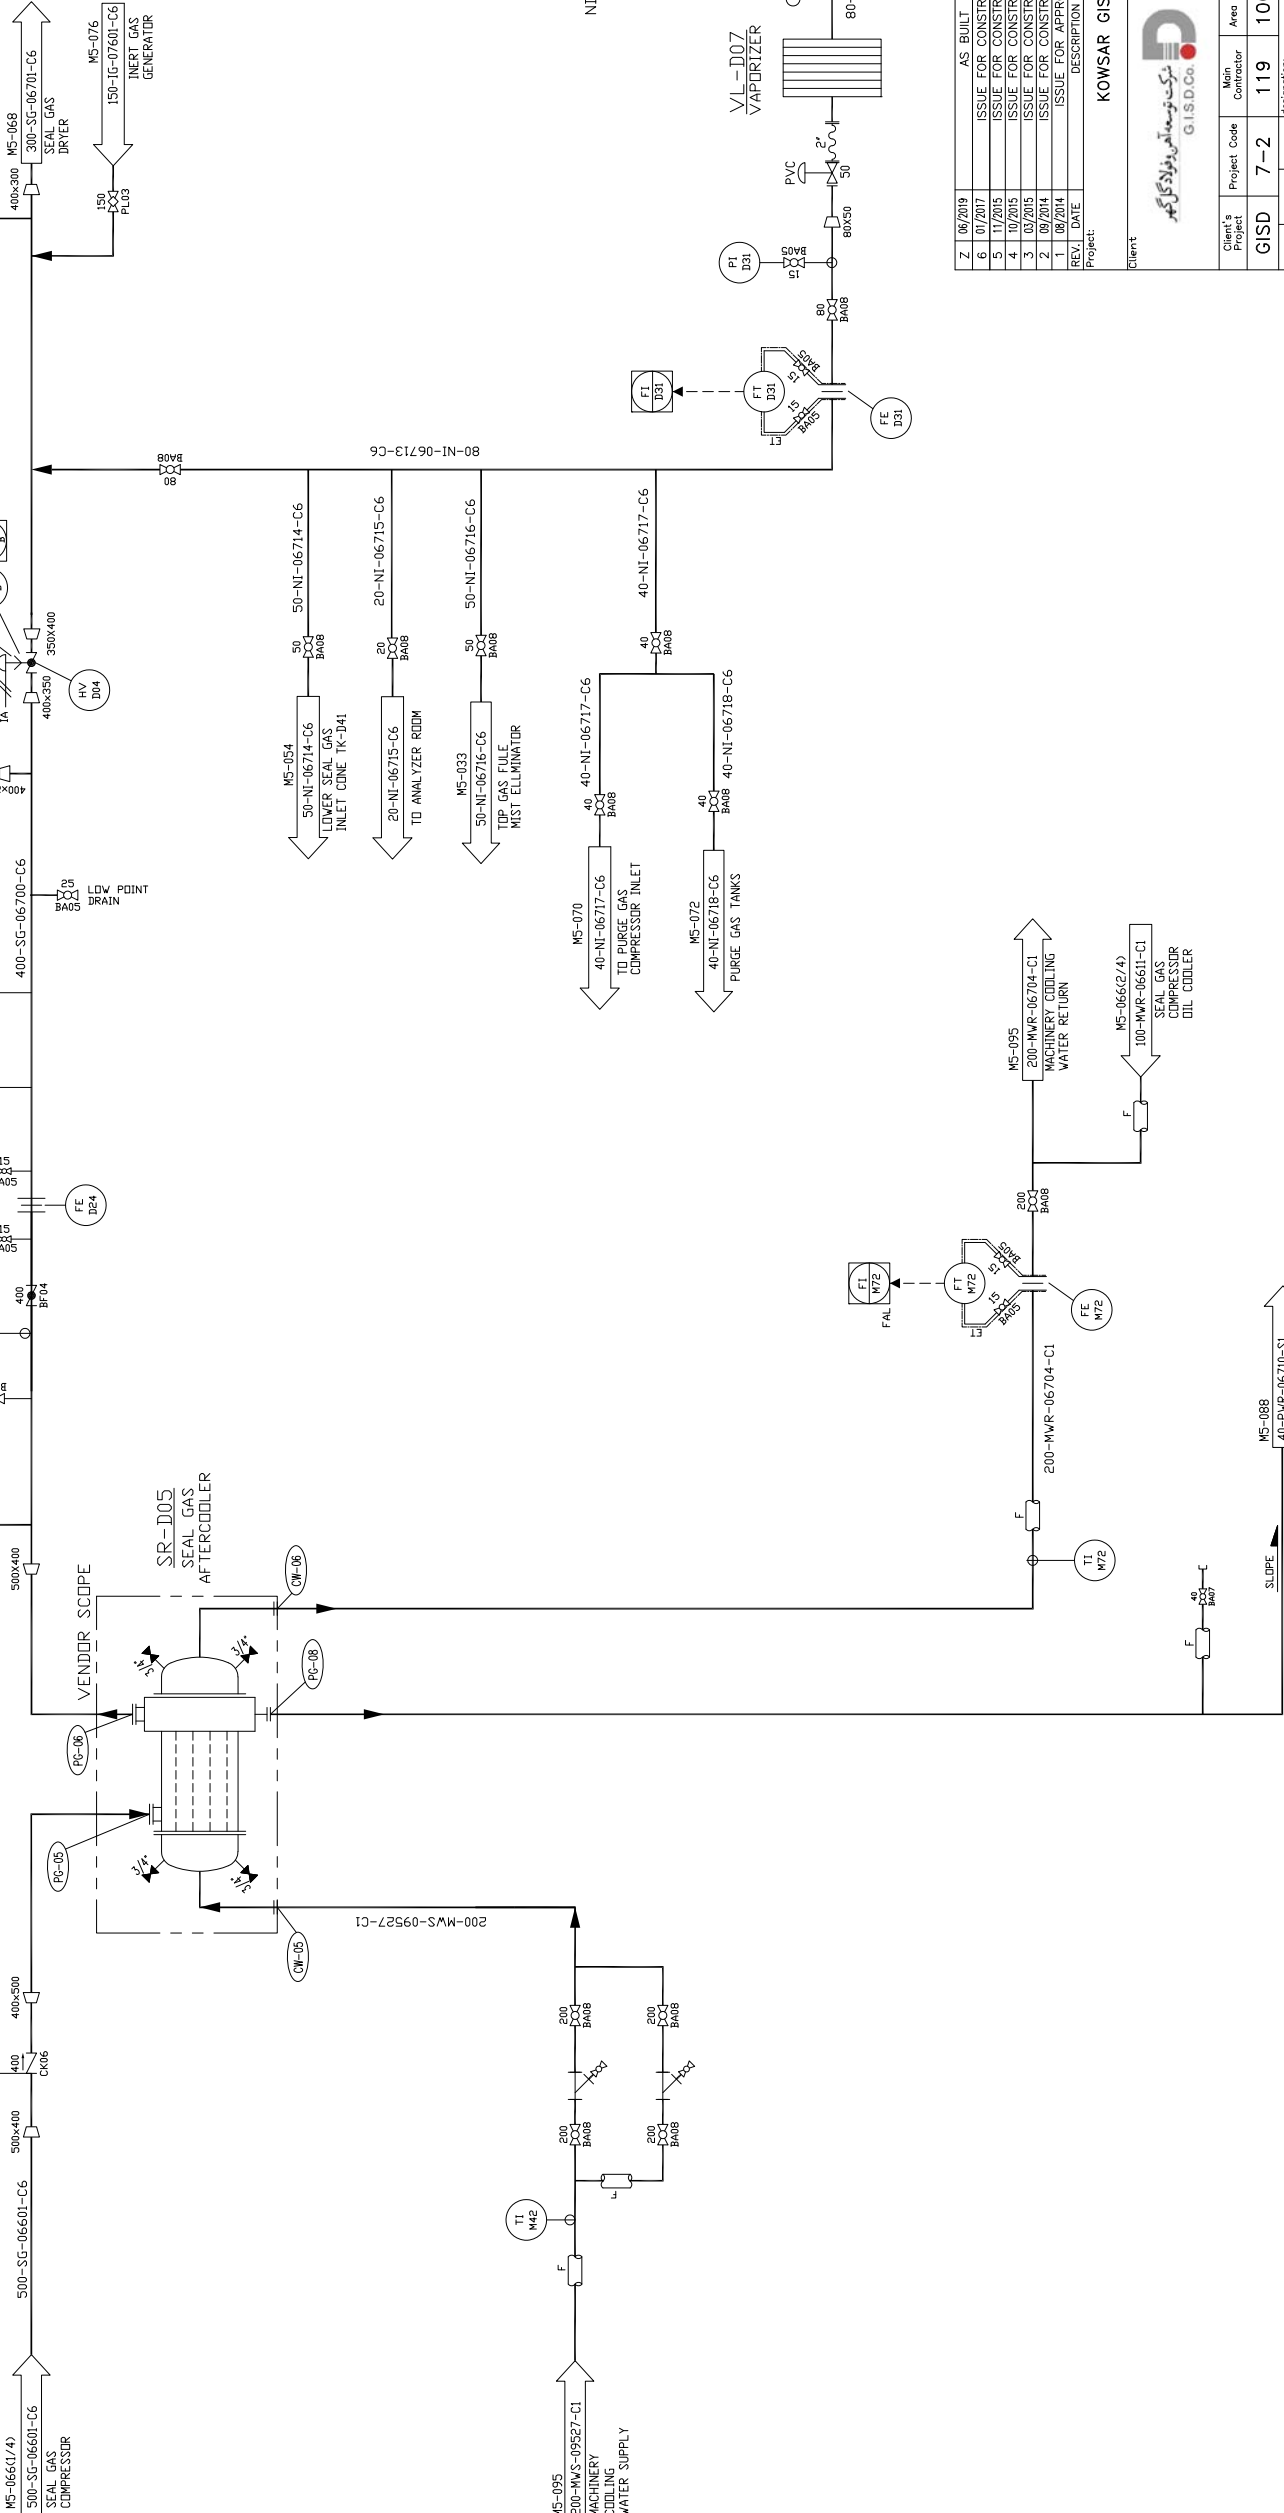

AS BUILT		ASB		KHALPOOR SHAGHOGI	
6	07/2017	ISSUE FOR CONSTRUCTION	IFC	MMTE	MMTE
5	11/2015	ISSUE FOR CONSTRUCTION	IFC	MMTE	MMTE
4	10/2015	ISSUE FOR CONSTRUCTION	IFC	MMTE	MMTE
3	03/2015	ISSUE FOR CONSTRUCTION	IFC	MMTE	MMTE
2	07/2015	ISSUE FOR CONSTRUCTION	IFC	MMTE	MMTE
1	08/2014	ISSUE FOR APPROVAL	IFC	MMTE	MMTE
REVL. DATE		DESCRIPTION		PURPOSE OF ISSUE	
				PREPARE	
				CHECK	
				APPROVE	

KOWSAR GISD MEGA MODULE PROJECT	
Client	شرکت توسعه و عمران گستر GISD Co. گستر
Contractor	شرکت مینرل و متالز تکنولوژیکال ENGINEERING CO. MTE