


REFERENCE	
	2 WAYS SOLENOID VALVE WITH SINGLE ACTUATOR
	3 WAYS SOLENOID VALVE WITH SINGLE ACTUATOR
	4 WAYS SOLENOID VALVE WITH SINGLE ACTUATOR
	4 WAYS SOLENOID VALVE WITH DOUBLE ACTUATOR
	BUTTERFLY VALVE
	GATE VALVE (AIR)
	BALL VALVE
	SAFETY VALVE
	DRAIN
	NEEDLE VALVE
	NON RETURN VALVE
	PRESSURE REDUCER
	PILOT OPERATED PRESSURE REDUCER
	GLOBE VALVE
	PISTON OR CYLINDER ACTUATOR
	AIR FILTER
	GATE VALVE (POWDER)
KC	TEMPORIZZATORE (ECONOMIZZATORE)/TIMER (ECONOMIZER)
PDSH	PRESSOSTATO DIFFERENZIALE ALTO/DIFFERENTIAL PRESSURE TRASMITTER HIGH
FB	FILTRO/FILTER
BLW	SOFFIANTE / BLOWER
XY	ELETTROVALVOLA / SOLENOID VALVE
PT	TRASMETTITORE DI PRESSIONE/ PRESSURE TRANSMITTER
PSV	VALVOLA DI SICUREZZA / SAFETY RELIEF VALVE
XV	VALVOLA AUTOMATICA / AUTOMATIC VALVE
LSH	LIVELLO ALTO / LEVEL SWITCH HIGH
LSL	LIVELLO BASSO / LEVEL SWITCH LOW
ZSH	POSIZIONE ALTO / LIMIT SWITCH (HIGH POSITION)
ZSL	POSIZIONE BASSO / LIMIT SWITCH (LOW POSITION)
PSH	PRESSIONE ALTO / PRESSURE SWITCH HIGH
PSL	PRESSIONE BASSO / PRESSURE SWITCH LOW
PC	CONTRATTORIO PRESSIONE / PRESSURE INDICATOR CONTROL
TT	TRASDUTTORE DI TEMPERATURA / TEMPERATURE TRANSDUCER
PI	MANOMETRO / MANOMETER
RV	ROTOCELLA / ROTOVALVE
FA	FILTRO ARIA / AIR FILTER
FI	INDICATORE DI FLUSSO/ FLOW INDICATOR
FT	TRASMETTITORE DI FLUSSO/ FLOW TRANSMITTER
BF	VALVOLA A FARFALLA MANUALE / MANUAL BUTTERFLY VALVE
BV	VALVOLA A SFERA MANUALE / MANUAL BALL VALVE
GV	VALVOLA A LAMA-SARACINESCA MANUALE / MANUAL GATE VALVE
NV	VALVOLA A SPILLO MANUALE / MANUAL NEEDLE VALVE
QV	VALVOLA SCARICO RAPIDO / QUICK DISCHARGE VALVE
PCV	REGOLATORE DI PRESSIONE / PRESSURE CONTROL VALVE
FBF	SISTEMA DI FLUIDIZZAZIONE / FLUIDIZING BIN BOTTOM
SSL	BASSA VELOCITA' / SPEED SWITCH LOW

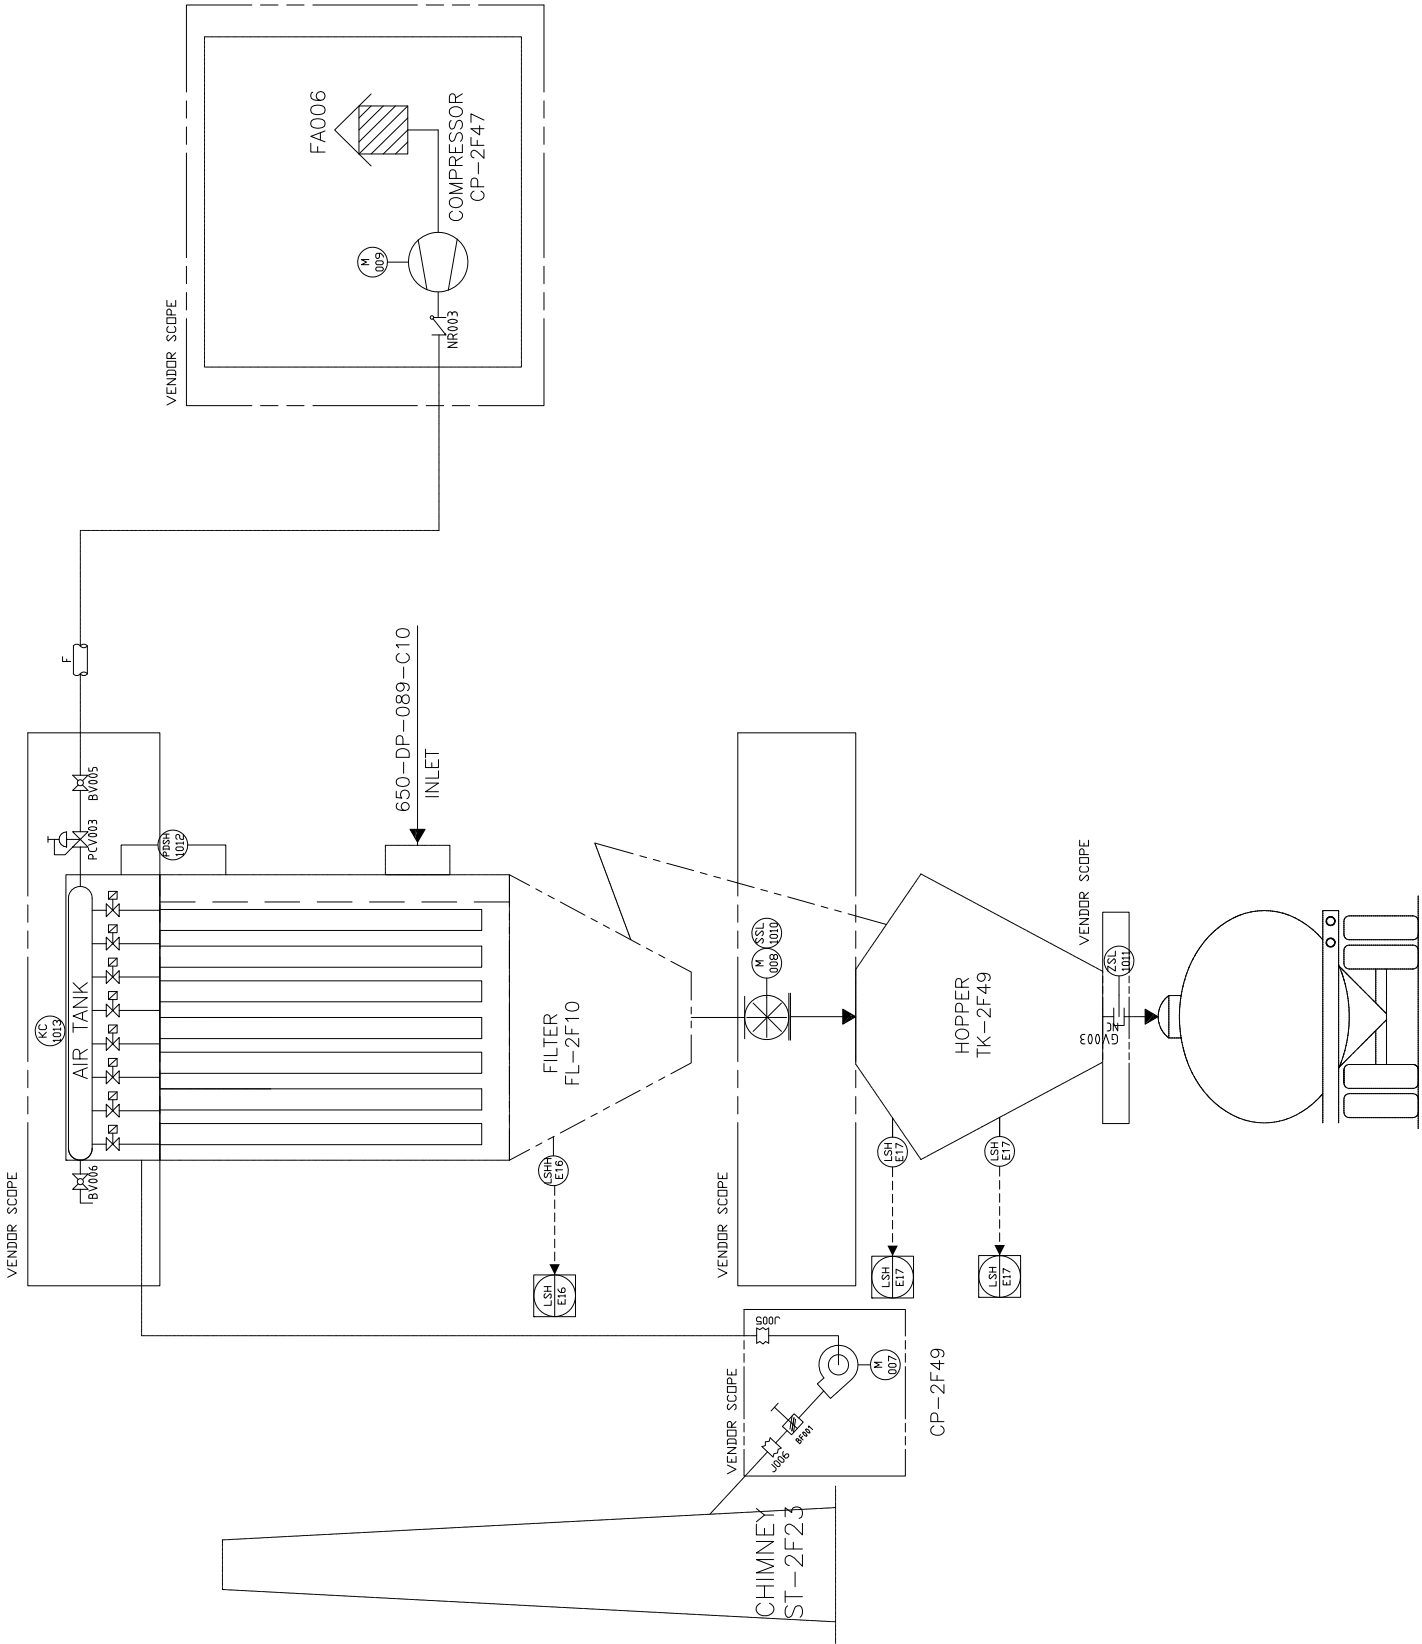

Z	06/2019	AS BUILT	ASIB	KHALPOOR	SHAGHAI	MOMIN	J
5	01/2017	ISSUE FOR CONSTRUCTION	IFC	MITE	SHAGHAI	MOMIN	J
4	10/2015	ISSUE FOR CONSTRUCTION	IFC	KHALPOOR	PARANI	KOMARI	J
3	03/2015	ISSUE FOR CONSTRUCTION	IFC	KHALPOOR	PARANI	KOMARI	J
2	01/2014	ISSUE FOR CONSTRUCTION	IFC	KHALPOOR	PARANI	KOMARI	J
1	08/2014	ISSUE FOR APPROVAL	IEA	KHALPOOR	PARANI	KOMARI	J
REV.	DATE	DESCRIPTION	PURPOSE OF ISSUE	PREPARE	CHECK	APPROVE	
Project:							

KOWSAR GISD MEGA MODULE PROJECT							
Client							
Contractor							
<div> </div> <div> <div>گیت نوٹس ٹیکنالوجی</div> <div>G.I.S.D. Co.</div> </div> <div> <div>گیت نوٹس ٹیکنالوجی</div> <div>MITE MINES & METALS TECHNOLOGICAL ENGINEERING CO.</div> </div>							
Client's Project	Project Code	Main Contractor	Area Code	Plant Group	Equipment Type	Document Discipline	Serial No.
GISD	7-2	119	1002	7	AA	04	P
	SIGNATURE	DATE	Designation				
DESIGNED	MITE	01/2017	PIPING & INSTRUMENTATION DIAGRAM				
PREPARED	MITE	01/2017	OXIDE DAY BIN & SCREEN & FURNACE FEED DUST COLLECTION SYSTEM				
CHECKED	SHAGHAI	01/2017	Drawing-No.				
APPROVED	MOHAMMAD ZADEH	01/2017	repl. by :				
			CONT. & PROJ. NO.				
			16				
			92/5499				

This document is the property of MITE. It may not be reproduced, stored in a retrieval system, or transmitted in any form or by any means, electronic, mechanical, photocopying, recording, or by any information storage and retrieval system, without the prior written permission of MITE Co.