


NOTES:

1. INSTALL VALVE SO THAT VALVE CENTERLINE IS SAME AS CENTERLINE OF NOZZLE.
2. SEE M3-061 FOR FLANGE DETAIL.
3. SHALL BE SUPPLIED BY SWITCH GEAR SUPPLIER.

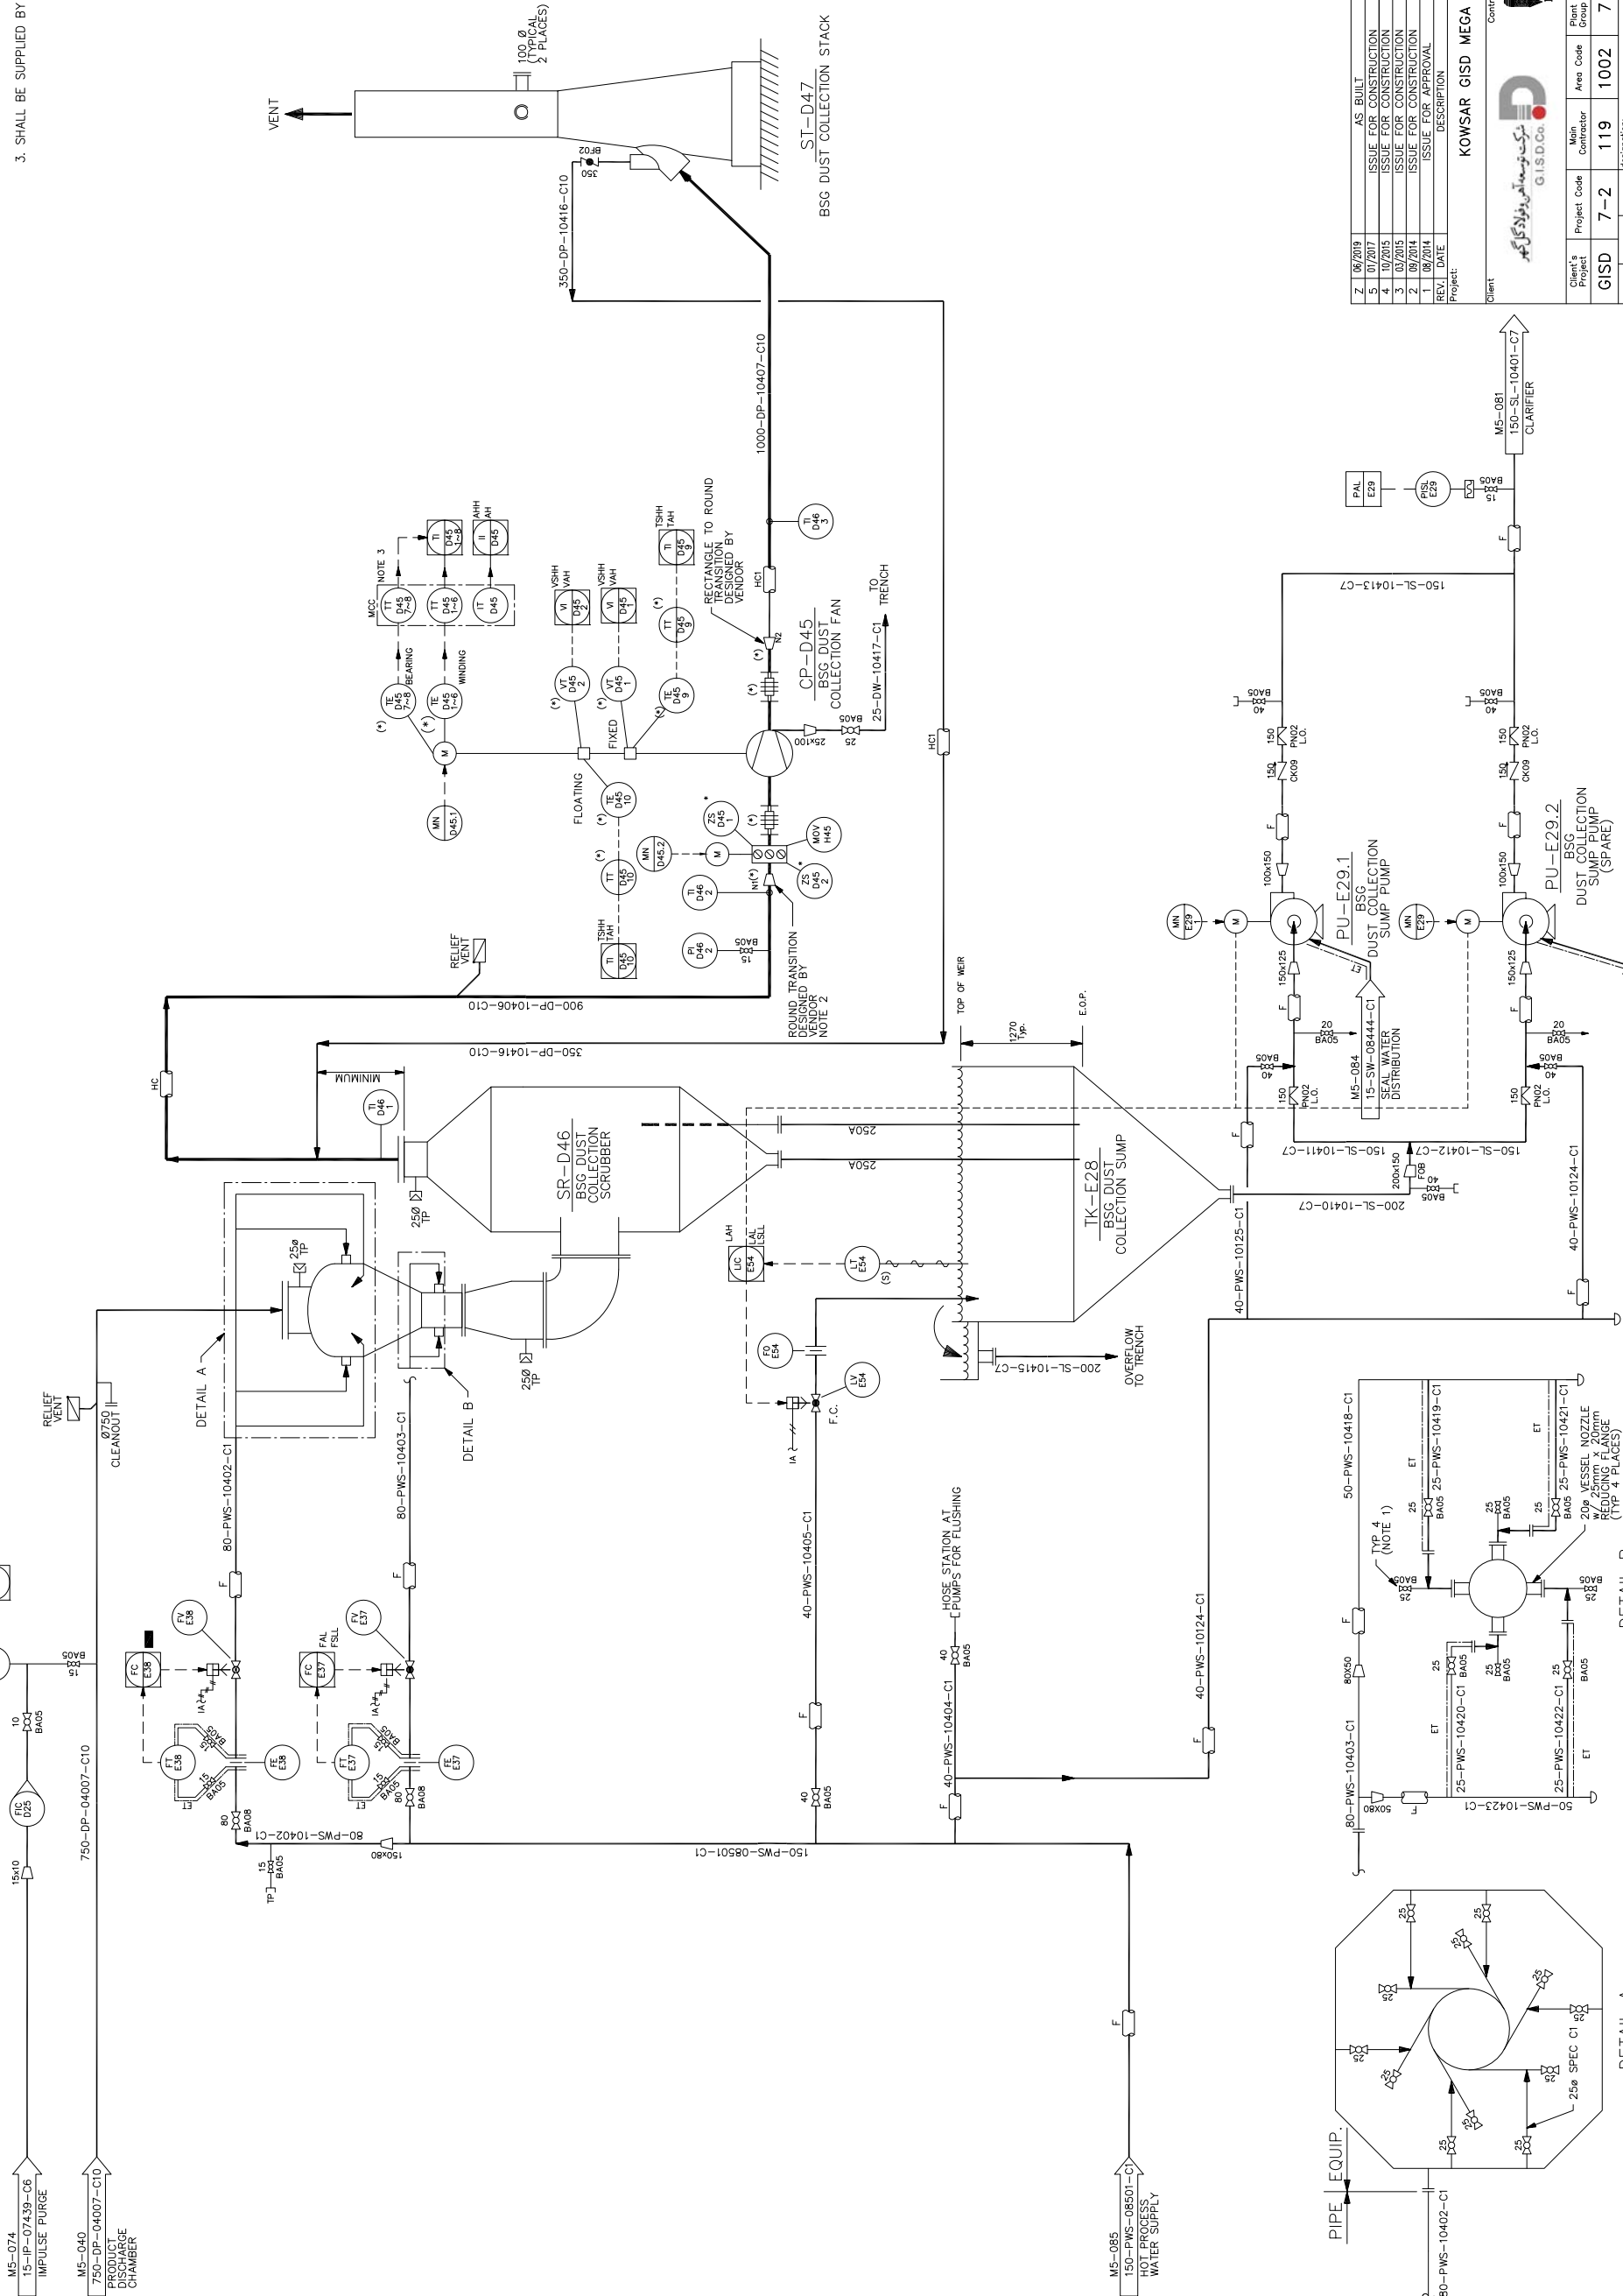

Z	06/2019	AS BUILT	ASB	KHALIPOOR SHAGHAGHI	MOHAMMAD
5	07/2017	ISSUE FOR CONSTRUCTION	IFC	MITE	SHAGHAGHI
4	10/2015	ISSUE FOR CONSTRUCTION	IFC	KHALIPOOR	PARVANI
3	03/2015	ISSUE FOR CONSTRUCTION	IFC	KHALIPOOR	PARVANI
1	08/2014	ISSUE FOR APPROVAL	IEA	KHALIPOOR	PARVANI
REV.	DATE	DESCRIPTION	PURPOSE OF ISSUE	PREPARE	CHECK

Project: KOWSAR GISD MEGA MODULE PROJECT					
Client: KOWSAR GISD MEGA MODULE PROJECT					
Contractor: KOWSAR GISD MEGA MODULE PROJECT					
Client's Project: KOWSAR GISD MEGA MODULE PROJECT					
Main Contractor: KOWSAR GISD MEGA MODULE PROJECT					
Area Code: 119					
Plant Code: 1002					
Equipment Code: 7					
Discipline: AA					
Serial No. 04					
Designation: PIPING & INSTRUMENTATION DIAGRAM					
Scale: AS SHOWN					
Drawing No. KGMMPC00M5104					
SHEET: 1/1					
CONT. & PROJ. NO: 92/5499					



Client's Project	Project Code	Project	Contractor	Main Contractor	Area Code	Plant Code	Equipment Code	Discipline	Serial No.
GISD	7-2	119	1002	7	AA	04	P	104	
DESIGNED	MMTE	01/2017							
PREPARED	MMTE	01/2017							
CHECKED	SHAGHAGHI	01/2017							
APPROVED	MMTE	01/2017							

Confidentiality: This document is confidential and its use is restricted to the project for which it was prepared. It may not be reproduced, stored, or transmitted in any form or by any means, electronic, mechanical, photocopying, recording, or by any information storage and retrieval system, without the prior written permission of MMTE Co.