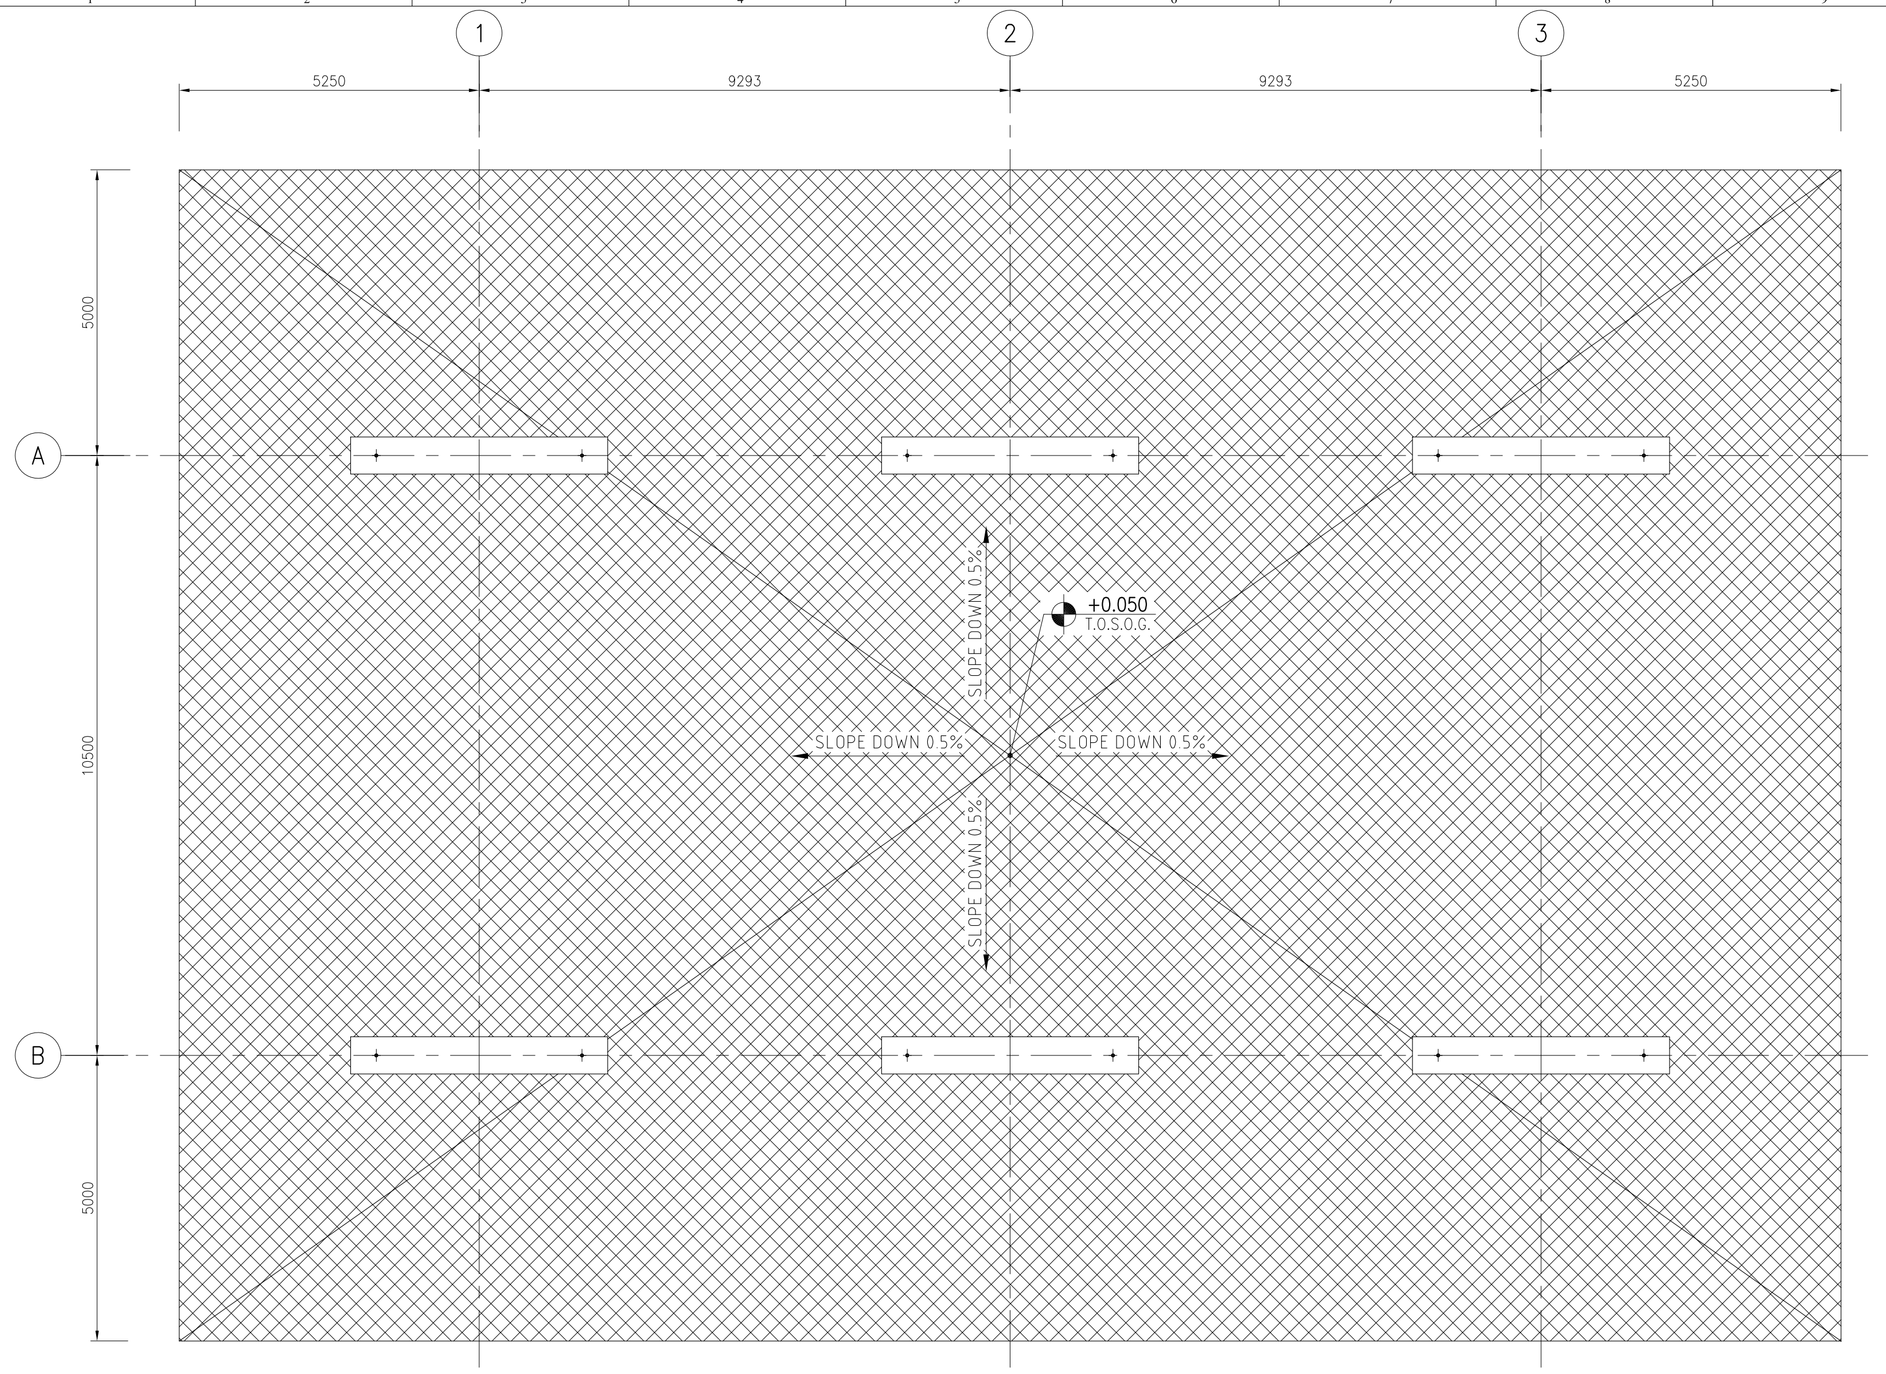

SLAB ON GRADE PLAN

Sc: 1/75

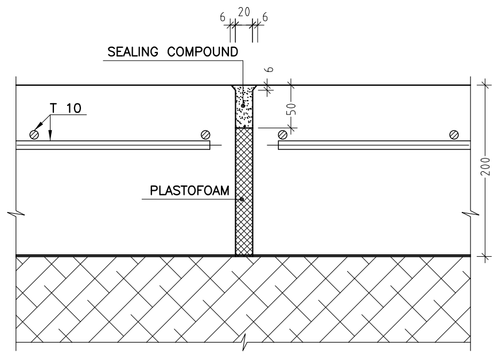

DETAIL–C

(EXPANSION JOINT OR SEPARATION JOINT)

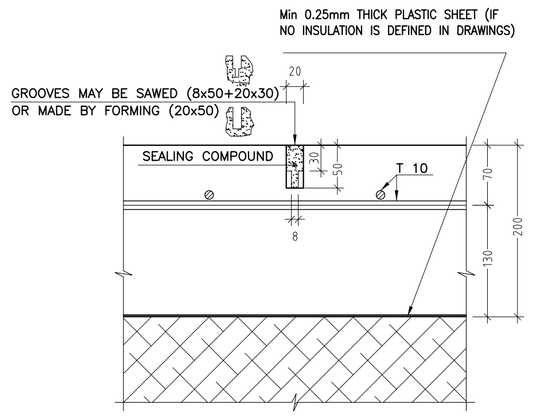

DETAIL–B

(DUMMY JOINT)

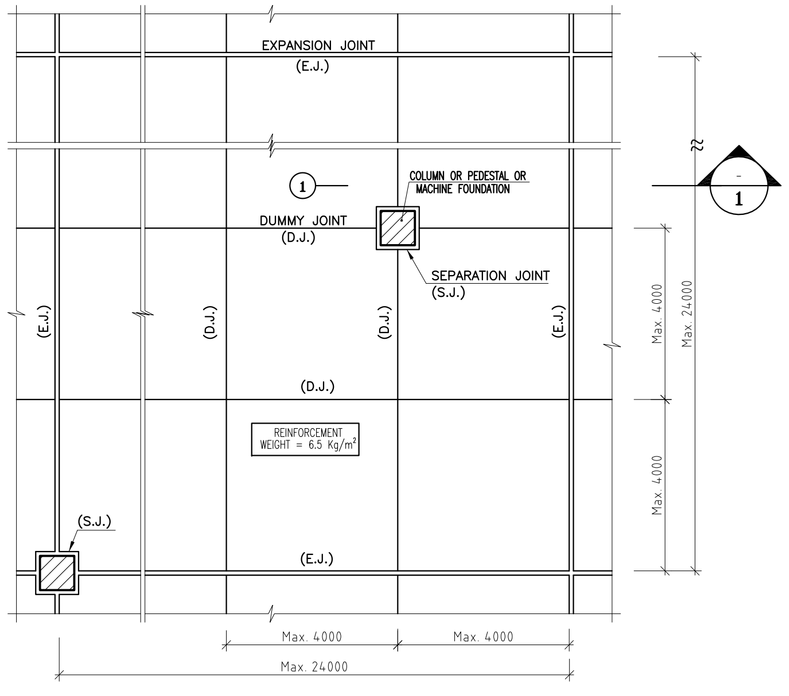

TYPICAL JOINTS ARRANGEMENT

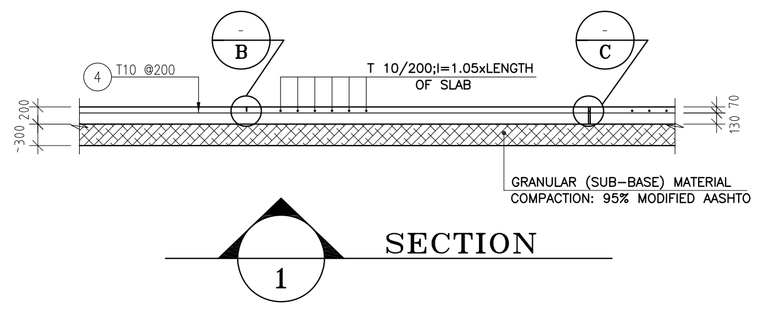

SECTION

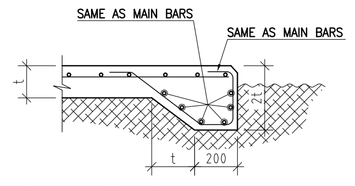

TYPICAL DETAIL FOR OUTER BOUNDARY

CONTRACTOR SHALL VERIFY ALL CONDITIONS AND DIMENSIONS IN THE FIELD BEFORE PROCEEDING WITH CONSTRUCTION. CONTRACTOR SHALL PROVIDE ALL RECESSES, SLEEVES, ANCHORS, SLOTS, ETC., AS REQUIRED BY OTHER TRADES AND SHALL ASCERTAIN PROPER LOCATION AND SIZE BEFORE INSTALLATION.

NOTES

1 – GROUND LEVEL (= GL ±0.00) IS EQUAL TO MSL +1699.900

2 – REINFORCING BARS MUST BE CUT AND BENT IN RIGHT ANGLE AND ADJUSTED ACCORDING TO THE SHAPE AND DIMENSION OF PEDESTALS AND BOUNDARIES.

3 – BARS OVERLAP SPLICE LENGTH MUST BE AT LEAST EQUAL TO: 500mm FOR T10.

4 – ALL SLAB ON GRADE SURFACES MUST BE ROUGH.

REV.	DATE	DESCRIPTION	PURPOSE OF ISSUE	PREPARE	CHECK	APPROVE
3						
Z	MAY.2019	AS BUILT	ASB	B.MAHOOTI	T.AHMADI	F.SHIRANDEH
1	JUL.2014	ISSUED FOR CONSTRAUCTION	IFC	S.RAZAVI	M.KARAMI	M.BARAZANDEH

Project: KOWSAR GISD MEGA MODULE PROJECT

Client: شرکت توسعه آهن و فولاد گل گهر G.I.S.D.Co.

Contractor: شرکت مهندسی فن آوری معدنی و فلزات MMTE MINES & METALS TECHNOLOGICAL ENGINEERING CO.

Client's Project	Project Code	Main Contractor	Area Code	Plant Group	Equipment Code	Document Type	Eng. Discipline	Serial No.
GISD	7–2	119	1001	7	TA	04	C	049

	SIGNATURE	DATE
DESIGNED	SH.GHARIBAN	JUL.2014
PREPARED	S.RAZAVI	JUL.2014
CHECKED	M.KARAMI	JUL.2014
APPROVED	M.BARAZANDEH	JUL.2014

designation: CIVIL DRAWING CORE AREA PURGE GAS TANK SLAB ON GRADE

drawing–No.: KGMM CB 36 C2 049

repl. for: | repl. by:

SCALE: AS SHOWN | REV.: Z | SIZE: A1 | SHEET: 1/1 | CONT. & PROJ. NO.: 92-5499

Confidential:This document discloses proprietary information. It may not be reproduced nor disclosed any person, nor used for any purpose, except wiht the written permission of MMTE Co