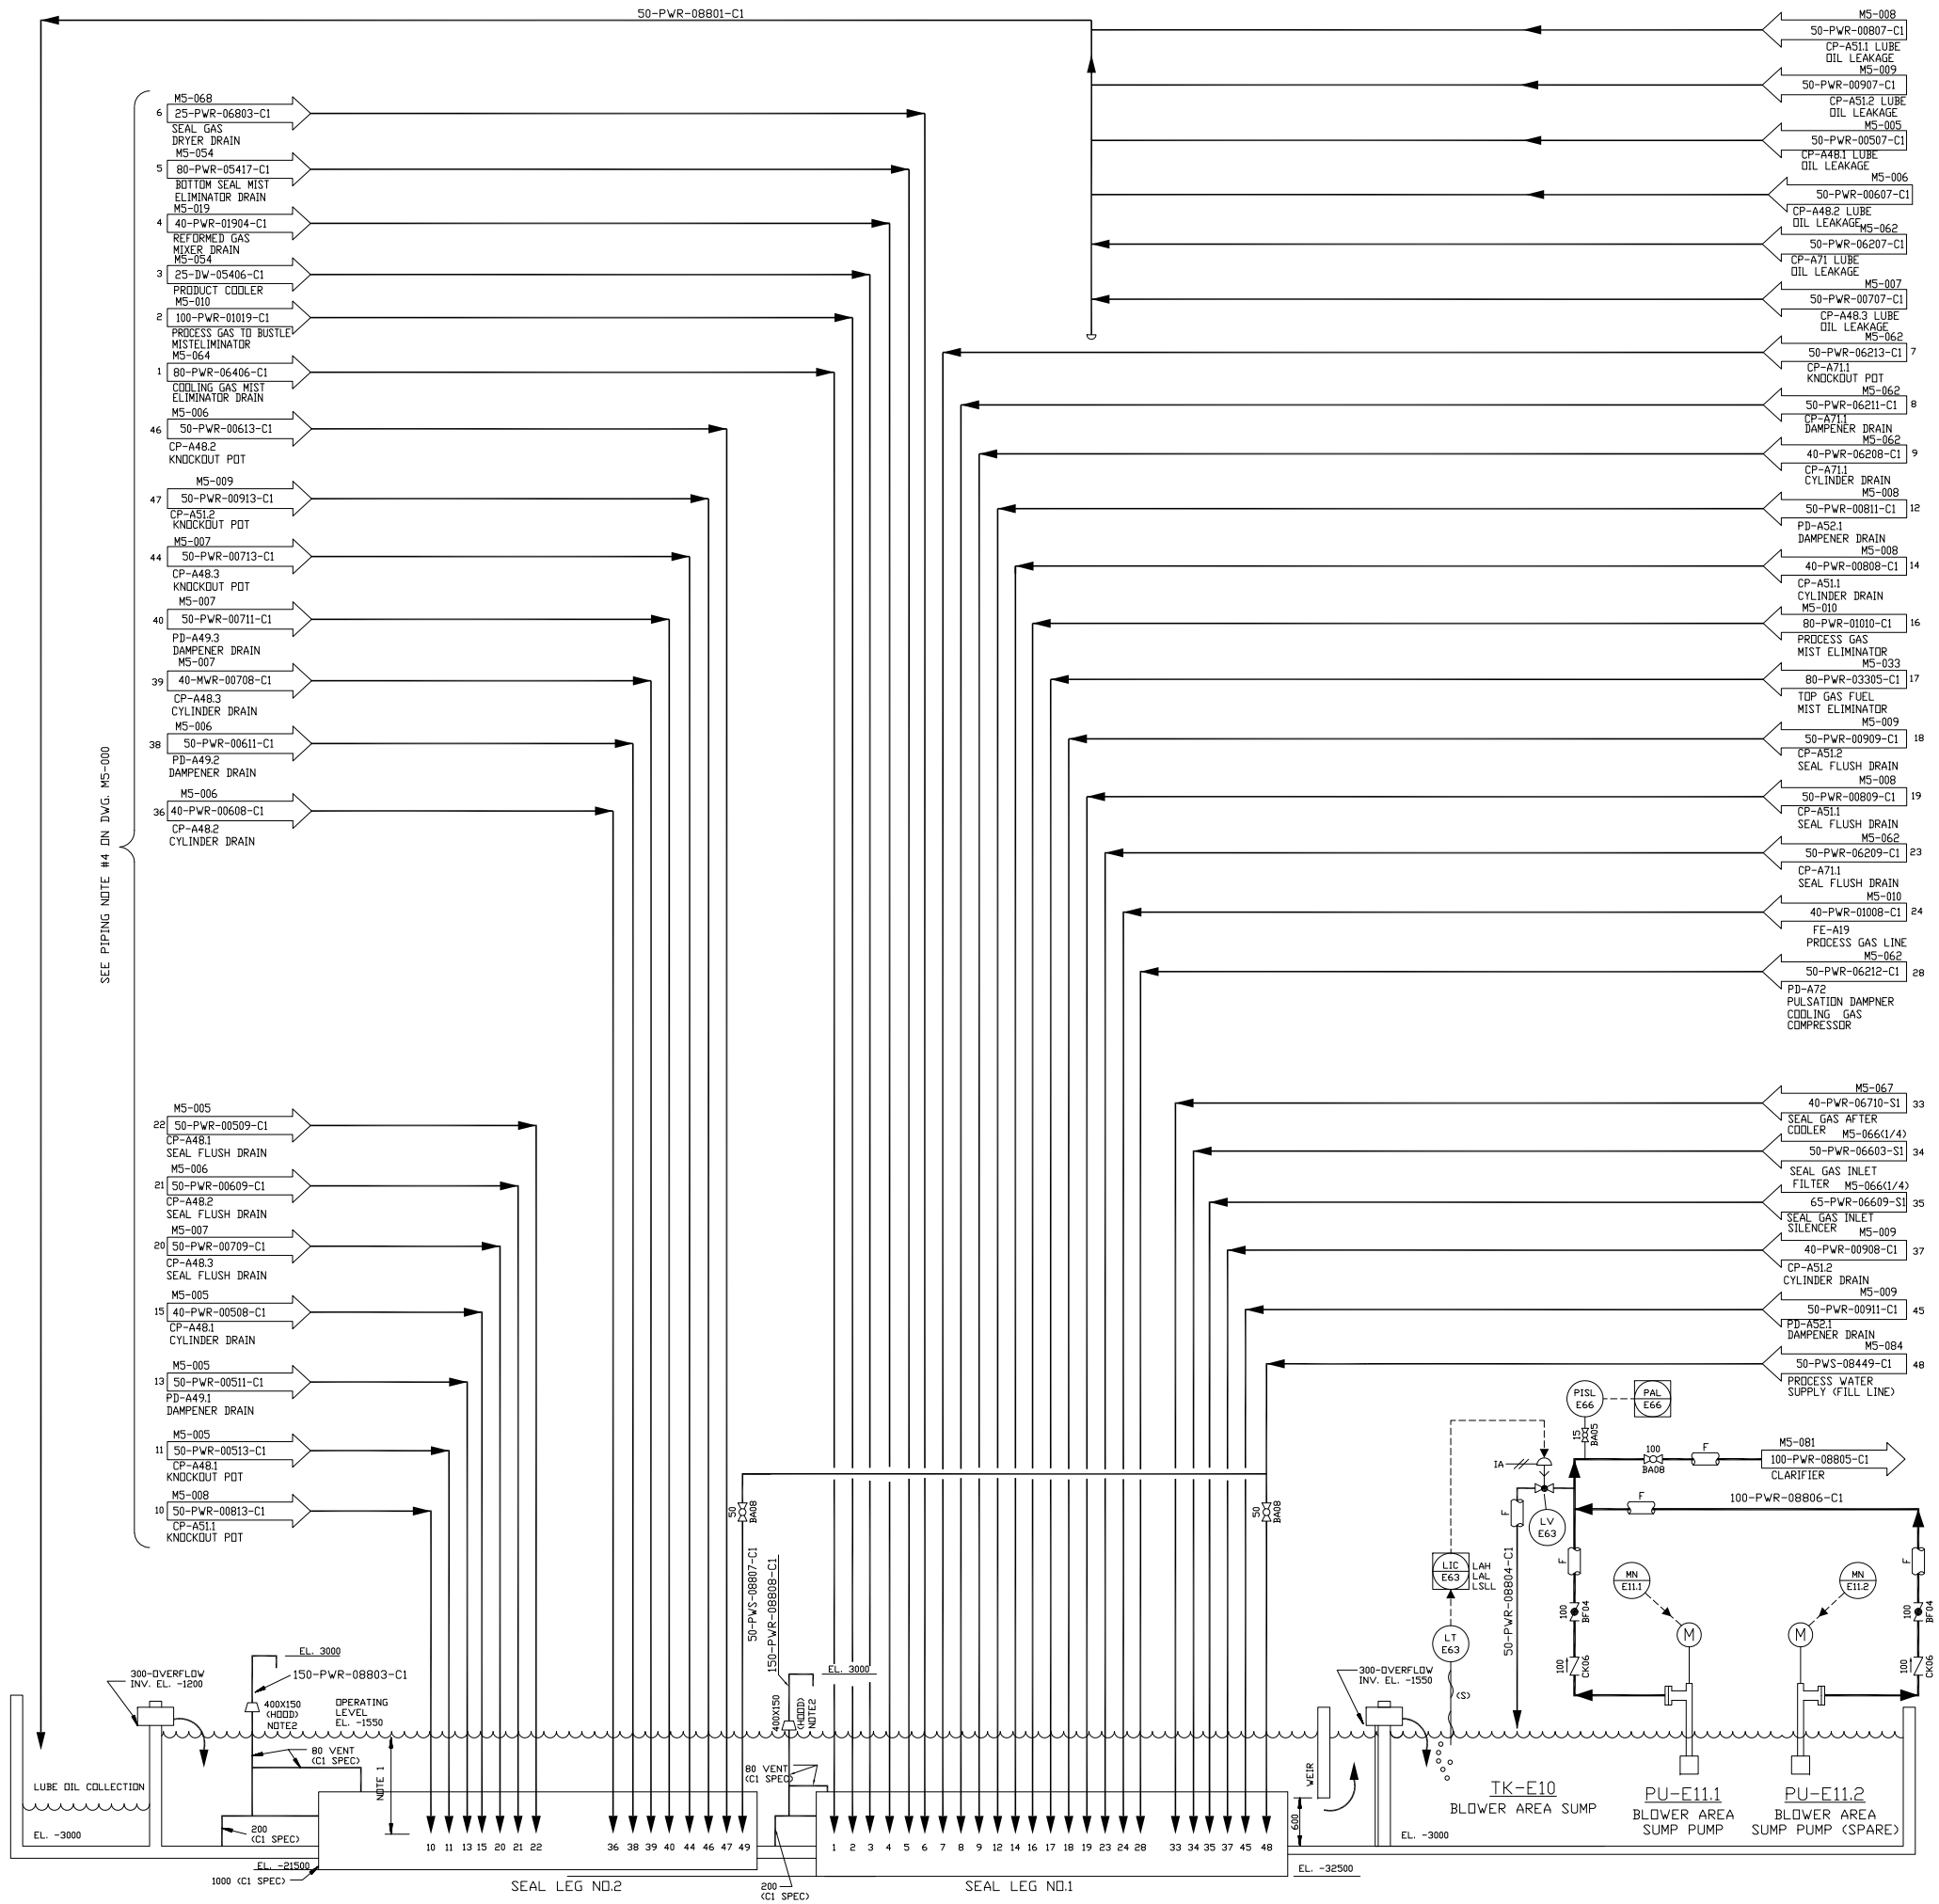

NOTES

1. ACTUAL LENGTH OF SEAL LEG FROM OPERATING WATER LEVEL (EL. -1550) TO E.O.P.

SEAL LEG NO.1

1	= 26980	18	= 30000
2	= 30160	19	= 30000
3	= 26900	23	= 26980
4	= 25230	24	= 30000
5	= 27400	28	= 26980
6	= 27400	31	= 29800
7	= 24000	33	= 29800
8	= 26980	34	= 4000
9	= 26980	35	= 4000
12	= 30000	37	= 30000
14	= 30000	45	= 30000
16	= 30000	48	= 30000
17	= 8670		

SEAL LEG NO.2

10	= 18580	36	= 18580
11	= 8670	38	= 18580
13	= 18580	39	= 18580
15	= 18580	40	= 18580
20	= 18580	44	= 8670
21	= 18580	46	= 8670
22	= 18580	47	= 18580
		49	= 18580

2. SEE M3-133 FOR DETAILS OF VAPOR HOOD

REV.	DATE	DESCRIPTION	PURPOSE OF ISSUE	PREPARE	CHECK	APPROVE
Z	06/2019	AS BUILT	ASB	KHALILPOOR	SHAGHAGHI	MOHAMMAD ZADEH
5	01/2017	ISSUE FOR CONSTRUCTION	IFC	MMTE	SHAGHAGHI	MOHAMMAD ZADEH
4	10/2015	ISSUE FOR CONSTRUCTION	IFC	KHALILPOOR	PARVANI	KIOMARSI
3	03/2015	ISSUE FOR CONSTRUCTION	IFC	KHALILPOOR	PARVANI	KIOMARSI
2	09/2014	ISSUE FOR CONSTRUCTION	IFC	KHALILPOOR	PARVANI	KIOMARSI
1	08/2014	ISSUE FOR APPROVAL	IFA	KHALILPOOR	PARVANI	KIOMARSI

Project: KOWSAR GISD MEGA MODULE PROJECT

Client: G.I.S.D.Co. شرکت توسعه آهن و فولاد گل گهر

Contractor: MMTE MINES & METALS TECHNOLOGICAL ENGINEERING CO.

Client's Project	Project Code	Main Contractor	Area Code	Plant Group	Equipment Code	Document Type	Eng. Discipline	Serial No.
GISD	7-2	119	1002	7	AA	04	P	088

	SIGNATURE	DATE
DESIGNED	MMTE	01/2017
PREPARED	MMTE	01/2017
CHECKED	SHAGHAGHI	01/2017
APPROVED	MOHAMMAD ZADEH	01/2017

designation: PIPING & INSTRUMENTATION DIAGRAM BLOWER AREA SUMP

drawing-No.: KGMMPC00M5088

repl. for: | repl. by :

SCALE: AS SHOWN | REV.: Z | SIZE: A3 | SHEET: 1/1 | CONT. & PROJ. NO. 92/5499

Confidential:This document discloses proprietary information. It may not be reproduced nor disclosed any person, nor used for any purpose, except wiht the written permission of MMTE Co