ITEM ID	QTY	MODEL CODE	MODEL FAMILY	MANUFACTURER
38	2	Pressure Gauge-0-250 bar	Guage	WIKA
39	3	HDA 4746-A-400-000	Pressure Transmitter	Hydac
46	4	KHM32F311141	Ball Valve	Hydac
47.	1	Junction Box	Junction Box	Iranian Manufacturer
53.	1	SAF32M12T200A-S309	Safety Block	Hydac
54	2	VUR114SP1-15S	Check Valve	Oleoweb
55.	1	SB330-50A1/112U-330A	Accumulator	Hydac
56	4	ZBE 08-05	Female connector	Hydac
57.	1	EVS 3106-A-0300	Flow Meter	Hydac
58.	1	XG2V-6GW	Pressure Reducing Valve	Eaton Vickers
59.	1	02-104807(F32)	Card Holder	Eaton Vickers
60.	1	EEA-PAM-571-A-32	Proportional Valve Amplifier	Eaton Vickers
61.	1	CVU-16-EFP1-B29-19-3	Slip-in Cartridge	Eaton Vickers
64.	1	DG5V 7 2A 2 MU H7 30	Pilot Operated Directional Valve	Eaton-Vickers
65.	1	Hydraulic Manifold	Hydraulic Manifold	HK
101.	1	Valve Stand	Valve Stand	HK
112.	1	125/90/381	Hydraulic Cylinder	HK

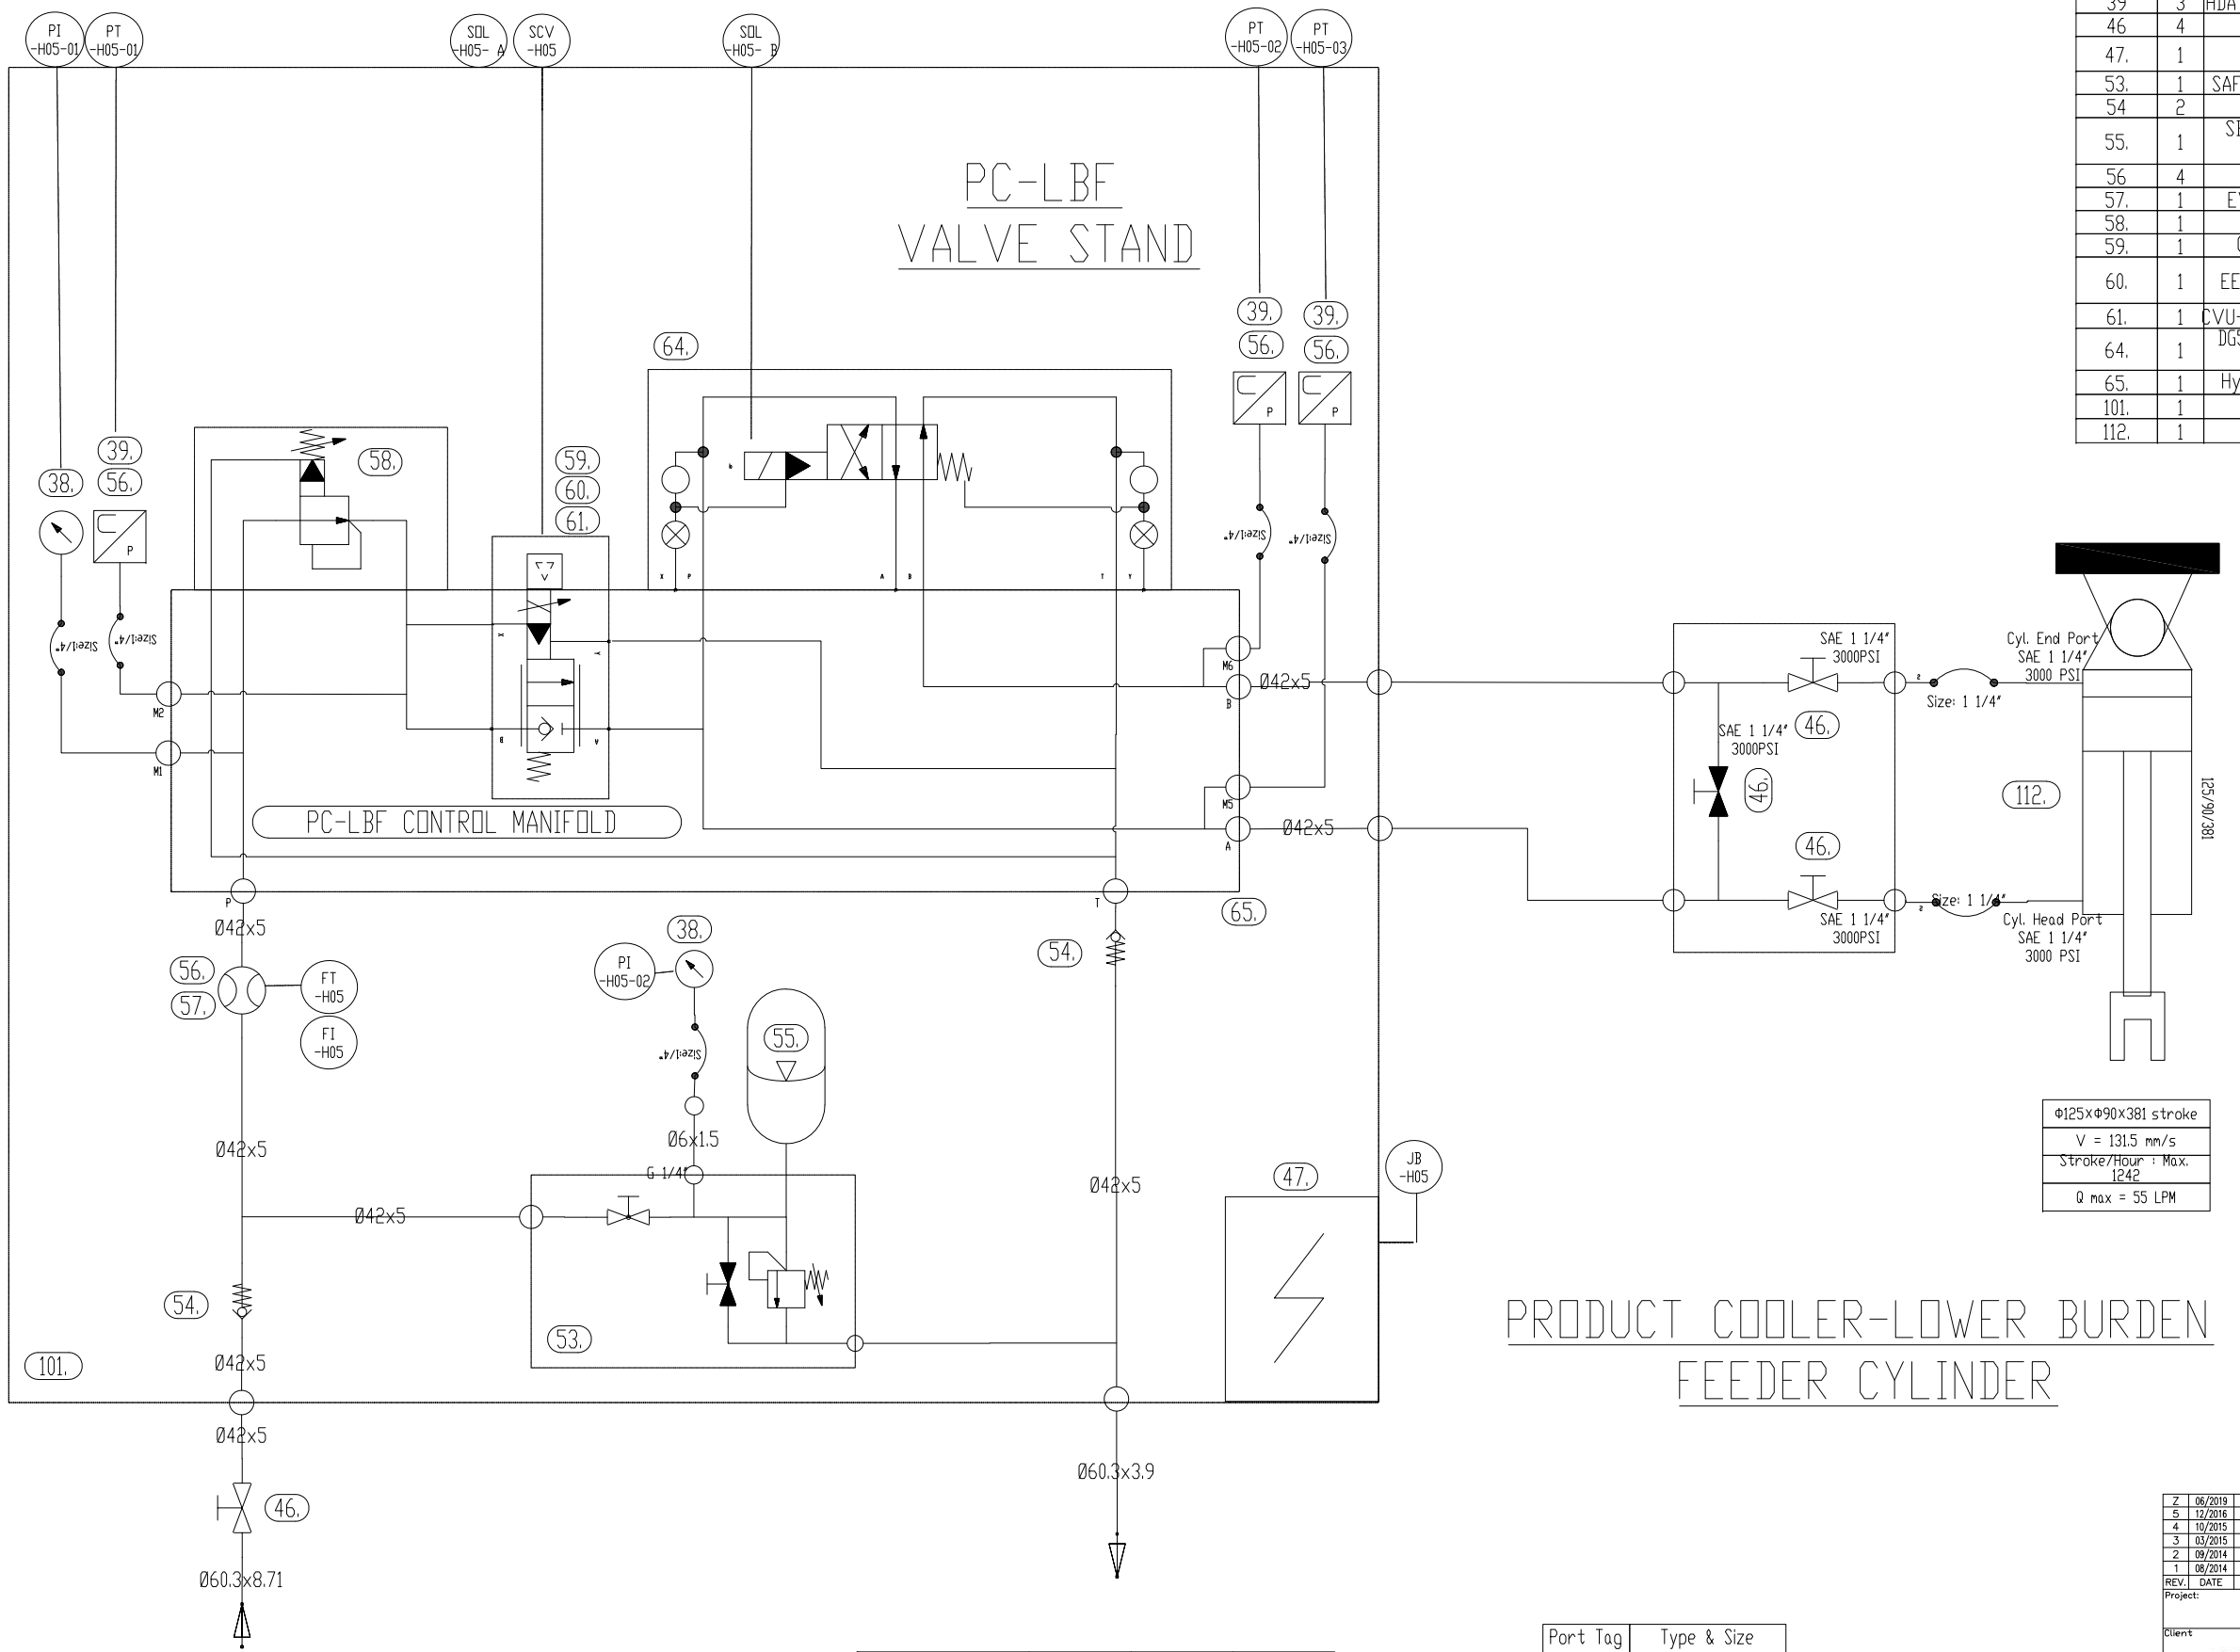

Φ125xΦ90x381 stroke
V = 131.5 mm/s
Stroke/Hour : Max. 1242
Q max = 55 LPM

PRODUCT COOLER-LOWER BURDEN FEEDER CYLINDER

Movement \ Output	SOL-H05-A	SOL-H05-B	SCV-H05
Up	Energized	De-Energized	4...20 mA
Down	Energized	Energized	4...20 mA
Non-Movement	De-Energized	-	-

Port Tag	Type & Size
M1..M6	G 1/4"
P	SAE 1 1/4" 3000PSI
A	SAE 1 1/4" 3000PSI
B	SAE 1 1/4" 3000PSI
T	SAE 1 1/4" 3000PSI

REV.	DATE	DESCRIPTION	PREPARE	CHECK	APPROVE
Z	06/2019	AS BUILT	ASB	KHALILPOOR	SHAGHAGHI
5	12/2016	ISSUE FOR CONSTRUCTION	IFC	MUSAVI	SHAGHAGHI
4	10/2015	ISSUE FOR CONSTRUCTION	IFC	KHALILPOOR	PARVANI
3	03/2015	ISSUE FOR CONSTRUCTION	IFC	KHALILPOOR	PARVANI
2	09/2014	ISSUE FOR CONSTRUCTION	IFC	KHALILPOOR	PARVANI
1	08/2014	ISSUE FOR APPROVAL	IFA	KHALILPOOR	PARVANI

Project: KOWSAR GISD MEGA MODULE PROJECT

Client: شرکت توسعه آهن و فولاد گل گهر G.I.S.D.Co.

Contractor: MMTE MINES & METALS TECHNOLOGICAL ENGINEERING CO.

Client's Project	Project Code	Main Contractor	Area Code	Plant Group	Equipment Code	Document Type	Eng. Discipline	Serial No.
GISD	7-2	119	1002	7	AA	04	P	112

	SIGNATURE	DATE
DESIGNED	MMTE	12/2016
PREPARED	MUSAVI	12/2016
CHECKED	SHAGHAGHI	12/2016
APPROVED	MOHAMMAD ZADEH	12/2016

designation: PIPING & INSTRUMENTATION DIAGRAM FURNACE EQUIPMENT HYDRAULIC SYSTEM

drawing-No.: KCMMPC00M5112

repl. for: repl. by :

SCALE: AS SHOWN | REV.: Z | SIZE: A3 | SHEET: 2/3 | CONT. & PROJ. NO: 92/5499

Confidential:This document discloses proprietary information. It may not be reproduced nor disclosed any person, nor used for any purpose, except wht the written permission of MMTE Co