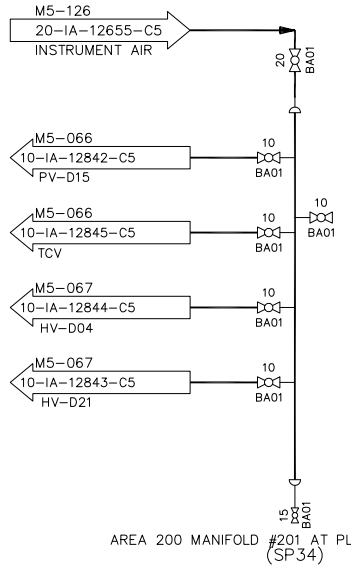

AREA 200 MANIFOLD #201 AT PLATFORM EL. 1300
(SP34)

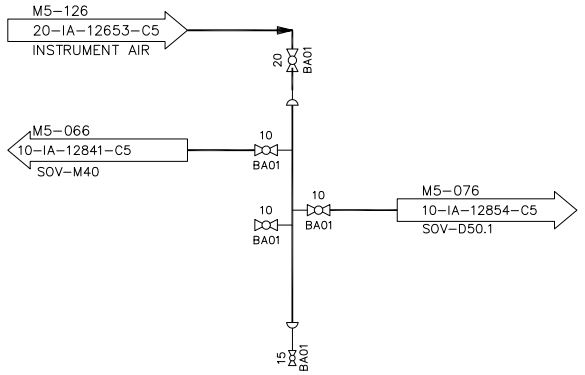

AREA 200 MANIFOLD #206 AT PLATFORM EL. 1300
(SP33)

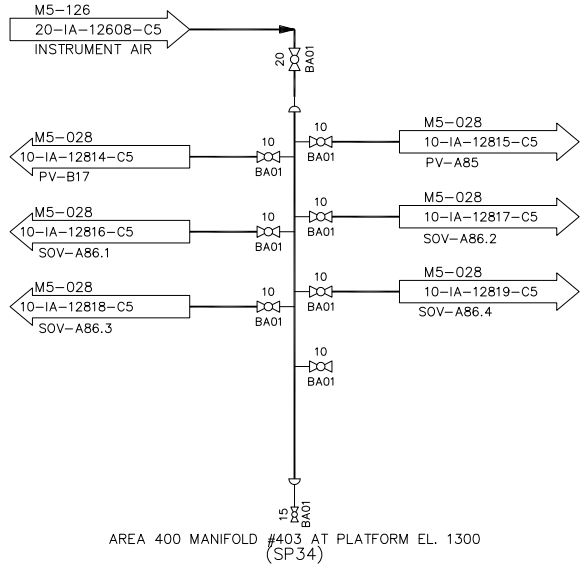

AREA 400 MANIFOLD #403 AT PLATFORM EL. 1300
(SP34)

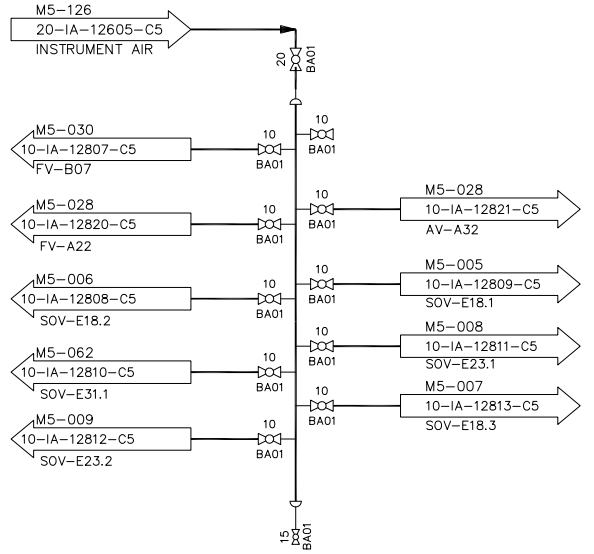

AREA 400 MANIFOLD #404 AT PLATFORM EL. 1300
(SP33)

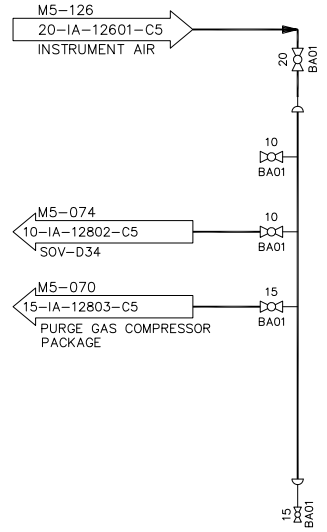

AREA 400 MANIFOLD #402 AT PLATFORM EL. 1300
(SP34)

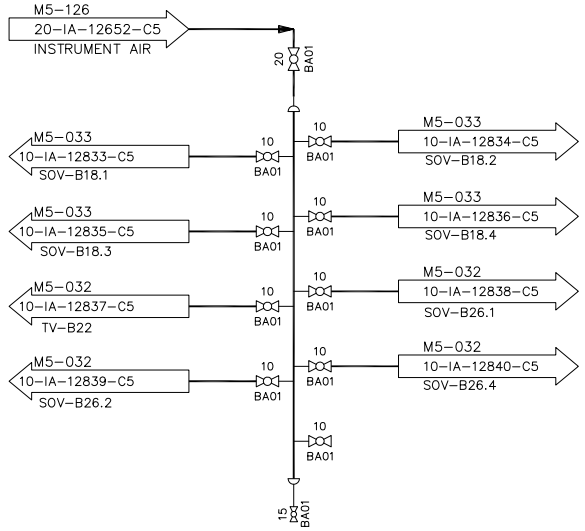

AREA 200 MANIFOLD #203 AT PLATFORM EL. 9200
(SP34)

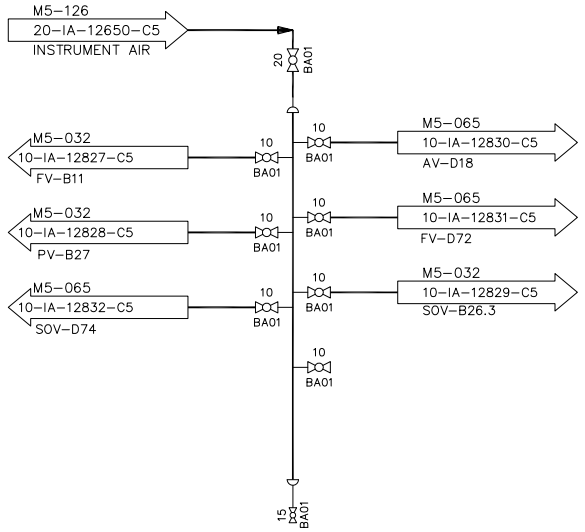

AREA 200 MANIFOLD #204 AT PLATFORM EL. 9200
(SP34)

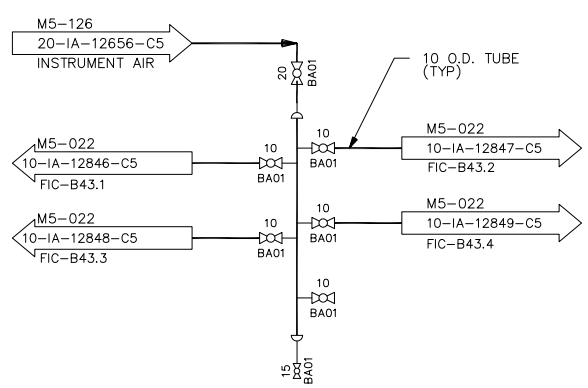

AREA 200 MANIFOLD #205 AT PLATFORM EL. 9200
(SP33)

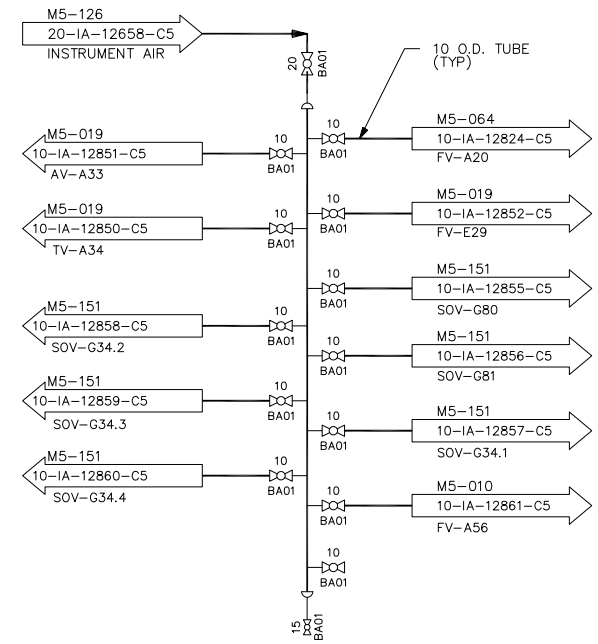

AREA 200 MANIFOLD #202 AT PLATFORM EL. 17560
(SP33)

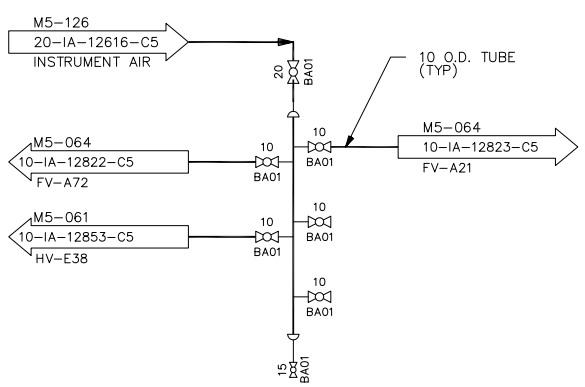

AREA 100 MANIFOLD #119 AT PLATFORM EL. 19700
(SP33)

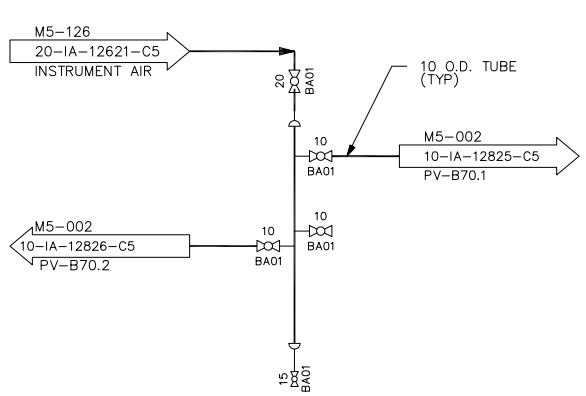

AREA 100 MANIFOLD #116 AT PLATFORM EL. 67150
(SP33)

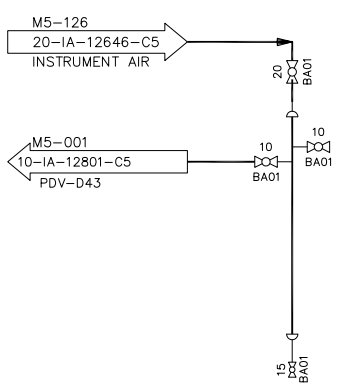

AREA 100 MANIFOLD #120 AT PLATFORM EL. 77400
(SP33)

REV.	DATE	DESCRIPTION	PURPOSE OF ISSUE	PREPARE	CHECK	APPROVE
Z	06/2019	AS BUILT	ASB	KHALILPOOR	SHAGHAGHI	MOHAMMAD ZADEH
5	01/2017	ISSUE FOR CONSTRUCTION	IFC	MMTE	SHAGHAGHI	MOHAMMAD ZADEH
4	10/2015	ISSUE FOR CONSTRUCTION	IFC	KHALILPOOR	PARVANI	KIOMARSI
3	02/2015	ISSUE FOR CONSTRUCTION	IFC	KHALILPOOR	PARVANI	KIOMARSI
2	09/2014	ISSUE FOR CONSTRUCTION	IFC	KHALILPOOR	PARVANI	KIOMARSI
1	08/2014	ISSUE FOR APPROVAL	IFA	KHALILPOOR	PARVANI	KIOMARSI

Project:
KOWSAR GISD MEGA MODULE PROJECT

Client: شرکت توسعه آهن و فولاد گل گهر G.I.S.D.Co.

Contractor: شرکت مهندسی فلزات و معادن MMTE MINES & METALS TECHNOLOGICAL ENGINEERING CO.

Client's Project	Project Code	Main Contractor	Area Code	Plant Group	Equipment Code	Document Type	Eng. Discipline	Serial No.
GISD	7-2	119	1002	7	AA	04	P	128

	SIGNATURE	DATE
DESIGNED	MMTE	01/2017
PREPARED	MMTE	01/2017
CHECKED	SHAGHAGHI	01/2017
APPROVED	MOHAMMAD ZADEH	01/2017

designation:
PIPING & INSTRUMENTATION DIAGRAM
INSTRUMENT AIR DISTRIBUTION-USERS

drawing-No.
KGMMPG00M5128

repl. for:

repl. by :

SCALE: AS SHOWN
REV.: Z
SIZE: A3
SHEET: 1/1
CONT. & PROJ. NO: 92/5499

Confidential:This document discloses proprietary information. it may not be reproduced nor disclosed any person, nor used for any purpose, except wiht the written permission of MMTE Co